

LABOR AND MATERIALS

_____	Copper Lead	Connection	_____	\$	_____
_____	Curb	Cock Valve T.S. & V.	_____ in.	\$	_____
_____	Service box Old returned	Short 3-1/2 x 4-1/2 Long 4-1/2 x 5-1/2	_____	\$	_____
30'	Ft. 3/4"	Copper G.I. C.I.	Pipe at	\$	_____
_____	Nipples	_____ in.	at	\$	_____
_____	Bushings	_____ to _____ in.	at	\$	_____
_____	Red'g				
_____	Inc'g				
_____	Union	_____ in.	at	\$	_____
_____	Meter	_____ in.	at	\$	_____
_____				\$	_____
_____	Compound Joints	at		\$	_____
_____	Maintenance Foreman			\$	_____
_____	Hrs. Water Maint. Man - 1	at		\$	_____
_____	Hrs. Water Maint. Man - 2	at		\$	_____
_____	Hrs. Garage Foreman	at		\$	_____
_____	Hrs. Labor	at		\$	_____
_____	Hrs. Compressor	at		\$	_____
_____				\$	_____
_____	Trucking			\$	_____
_____	Pav't Patch			\$	_____
_____				\$	_____
_____				\$	_____
_____				\$	_____
_____				\$	_____


EAST
BOYLSTON

St.
Pl.
Ave. No.

30

Name of Owner
CUGINI ENTERPRISES

Labor and Mat'l. Report 19

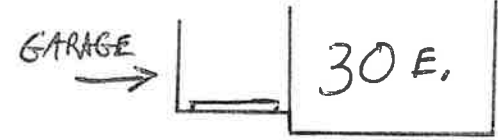

A = 28'
B = 29'10"

_____ Main Elev. of Main at tap _____

Gate at ● Gate at ●

● Curb Box