

**LABOR AND MATERIALS**

3/4 Copper } Connection \_\_\_\_\_ \$  
 Lead }  
 Curb } Cock \_\_\_\_\_ in. \$  
 Valve }  
 T.S. & V. }


Service box { Short 3-1/2 x 4-1/2 } \$  
 Old returned { Long 4-1/2 x 5-1/2 }

38 Ft. \_\_\_\_\_ in. { Copper } Pipe at \_\_\_\_\_ \$  
 { G.I. }  
 { C.I. }

Nipples \_\_\_\_\_ in. at \_\_\_\_\_ \$  
 Bushings \_\_\_\_\_ to \_\_\_\_\_ in. at \_\_\_\_\_ \$  
 Red'g \_\_\_\_\_  
 Inc'g \_\_\_\_\_  
 Union \_\_\_\_\_ in. at \_\_\_\_\_ \$  
 Meter \_\_\_\_\_ in. at \_\_\_\_\_ \$  
 \_\_\_\_\_ \$  
 Compound Joints at \_\_\_\_\_ \$  
 Maintenance Foreman \_\_\_\_\_ \$  
 Hrs. Water Maint. Man - 1 at \_\_\_\_\_ \$  
 Hrs. Water Maint. Man - 2 at \_\_\_\_\_ \$  
 Hrs. Garage Foreman \_\_\_\_\_ at \_\_\_\_\_ \$  
 Hrs. Labor \_\_\_\_\_ at \_\_\_\_\_ \$  
 Hrs. Compressor at \_\_\_\_\_ \$  
 \_\_\_\_\_ \$  
 Trucking \_\_\_\_\_ \$  
 Pav't Patch \_\_\_\_\_ \$  
 \_\_\_\_\_ \$  
 \_\_\_\_\_ \$  
 \_\_\_\_\_ \$  
 \_\_\_\_\_ \$

E BOYLSTON St. Ave. No. 32  
 Name of Owner  
 TAX ID # 309.16-8-20.2

Labor and Mat'l. Report for 2006

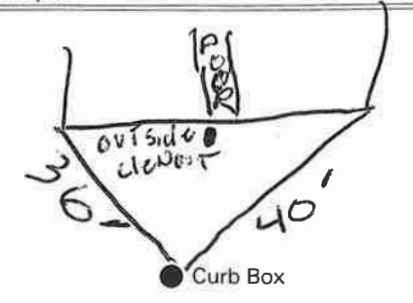

6" Main Elev. of Main at tap 4"  
 Gate at ● Gate at ●

● Curb Box

has outside clean under porch