


LABOR AND MATERIALS

Copper	} Connection	_____	\$ _____	
Lead				
Curb	} Cock	_____ in.	\$ _____	
				} Valve
Service box	} Short 3½ x 4½	_____	\$ _____	
Old returned				Long 4½ x 5½
6'4" Ft.	} Copper	_____ in.	\$ _____	
$\frac{3}{4}$ in.				_____
Nipples	_____ in. at _____	\$ _____		
Bushings	_____ to _____ in. at _____	\$ _____		
Red'g	} Coupl'gs _____ to _____ in. at _____	\$ _____		
Inc'g				
Union	_____ in. at _____	\$ _____		
Meter	_____ in. at _____	\$ _____		
Compound Joints	_____	\$ _____		
Maintenance Foreman	_____	\$ _____		
Hrs. Water Maint. Man-1	at _____	\$ _____		
Hrs. Water Maint. Man-2	at _____	\$ _____		
Hrs. Garage Foreman	at _____	\$ _____		
Hrs. Labor	_____ at _____	\$ _____		
Hrs. Compressor	at _____	\$ _____		
Trucking	_____	\$ _____		
Pav't Patch	_____	\$ _____		
		\$ _____		
		\$ _____		
		\$ _____		
		\$ _____		

E. BOYLSTON St. No. 36

Name of Owner HOWARD CRANNELL

Labor and Mat'l. Report JUNE 2000

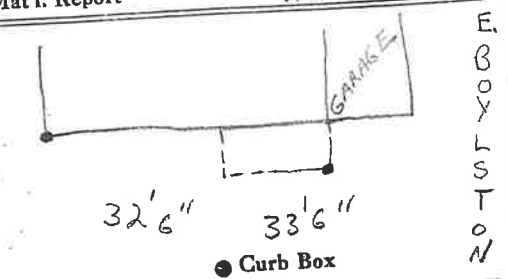

FAXON
Main Elev. of Main at tap

Gate at • Gate at •

• Curb Box

TAP ON FAXON