


# LABOR AND MATERIALS

_____	Copper	} Connection _____	\$ _____	
_____	Lead			
_____	Curb	} Cock Valve T.S. & V. } _____ in.	\$ _____	
_____			Service box { Short 3-1/2 x 4-1/2	\$ _____
_____			Old returned { Long 4-1/2 x 5-1/2	\$ _____
_____	Ft. _____ in.	{ Copper G.I. C.I. } Pipe at _____	\$ _____	
_____	Nipples _____	in. at _____	\$ _____	
_____	Bushings _____	to _____ in. at _____	\$ _____	
_____	Red'g			
_____	Inc'g			
_____	Union _____	in. at _____	\$ _____	
_____	Meter _____	in. at _____	\$ _____	
_____			\$ _____	
_____	Compound Joints at _____		\$ _____	
_____	Maintenance Foreman _____		\$ _____	
_____	Hrs. Water Maint. Man - 1 at _____		\$ _____	
_____	Hrs. Water Maint. Man - 2 at _____		\$ _____	
_____	Hrs. Garage Foreman _____	at _____	\$ _____	
_____	Hrs. Labor _____	at _____	\$ _____	
_____	Hrs. Compressor at _____		\$ _____	
_____			\$ _____	
_____	Trucking _____		\$ _____	
_____	Pav't Patch _____		\$ _____	
_____			\$ _____	
_____			\$ _____	
_____			\$ _____	
_____			\$ _____	

40 E. BOYLSTON <sup>St.</sup> <sub>40</sub>  
 Ave. No. 40

Name of Owner \_\_\_\_\_

Labor and Mat'l. Report ~~to~~ **JUNE 27, 2001**

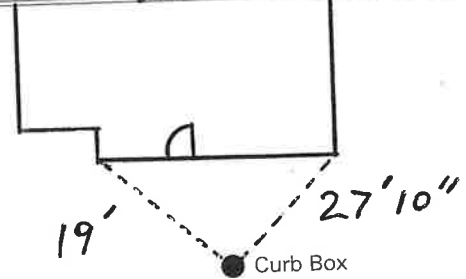

6" <sup>KH</sup> Main 6-27-2001 Elev. of Main at tap \_\_\_\_\_  
 Gate at ● Gate at ●

● Curb Box