

LABOR AND MATERIALS

1	Copper	{ Connection	3/4"	\$ 2.76
	Lead			
1	Curb	{ Cock Valve	3/4" in.	\$ 3.49
		T. S. & V.		
1	Service box	{ Short 3/4 X 4 1/2		\$ 4.74
	Old returned	{ Long 4 1/2 X 5 1/2		
		Buffer Rdway		
9	Ft.	{ Copper	Pipe at 38	\$ 3.42
		G. I.		
		C. I.		
	Nipples	in. at		\$
	Bushings	to in. at		\$
	Red'g			\$
	Inc'g	{ Coupl'gs	to in. at	\$
	Union	in. at		\$
	Meter	in. at		\$
	Lead Joints	at		\$
	Compound Joints	at		\$
	Hrs. Water Maint. Man-1	at		\$
6	Hrs. Water Maint. Man-2	at 1.24		\$ 7.44
1.4	Hrs. Labor	at 1.13		\$ 1.582
	Hrs. Labor	at		\$
	Hrs. Compressor	at		\$
	Compensation Ins.	at \$ 4.406 per C		\$ 1.02
	Trucking			\$ 1.00
	Pay't Patch			\$
	Tap by G.I.F.F.O.I.d. 4-28-53			\$
	O'head			\$

\$39.69


39.69

2865
West
Boylston

St. Pl
Ave. No. 8

Name of Owner
Lawrence

Labor and Mat'l. Report Apr. 28 1953

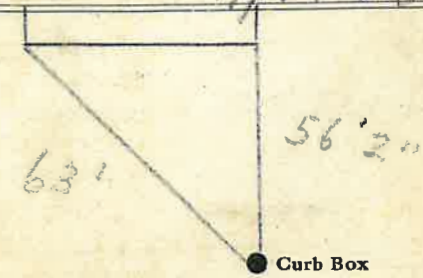

6" Main Elev. of Main at tap 4 1/2'

Gate at ● Gate at ●

TAX ID # 309.16-10-6

● Curb Box

