

LABOR AND MATERIALS


Copper	}	Connection	_____	\$ _____
Lead				
Curb	}	Cock	_____	\$ _____
	}	Valve	_____ in.	
	}	T. S. & V.	_____	
Service box	}	Short 3½ x 4½	_____	
Old returned	}	Long 4½ x 5½	_____	
				\$ _____
24 Ft. ¾ in.	}	Copper	_____	\$ _____
	}	G.I.	_____	
	}	G.I.	_____	
		Pipe at	_____	\$ _____
Nipples		in. at	_____	\$ _____
Bushings		to in. at	_____	\$ _____
Red'g	}	Coupl'gs	_____ to _____ in. at _____	\$ _____
Inc'g				
Union		in. at	_____	\$ _____
Meter		in. at	_____	\$ _____
			_____	\$ _____
Compound Joints		at	_____	\$ _____
Maintenance Foreman			_____	\$ _____
Hrs. Water Maint. Man—1		at	_____	\$ _____
Hrs. Water Maint. Man—2		at	_____	\$ _____
Hrs. Garage Foreman		at	_____	\$ _____
Hrs. Labor—		at	_____	\$ _____
Hrs. Compressor		at	_____	\$ _____
			_____	\$ _____
Trucking			_____	\$ _____
Pav't Patch			_____	\$ _____
			_____	\$ _____
			_____	\$ _____
			_____	\$ _____
			_____	\$ _____

St.
Pl.
Ave. No. 11

W. Boylston

Name of Owner _____

Labor and Mat'l. Report July 1992

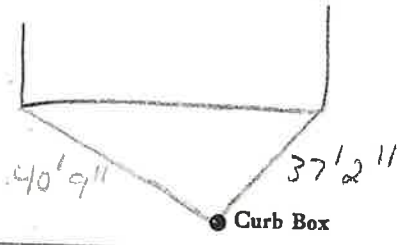

6 Main Elev. of
Main at tap _____

Gate at ● ● Gate at

● Curb Box