

LABOR AND MATERIALS


_____	Copper	} Connection	_____	\$	_____
_____	Lead		_____	\$	_____
_____	Curb	} Cock Valve T.S. & V.	_____	in.	\$
_____			_____	\$	_____
_____			_____	\$	_____
_____	Service box	} Short 3-1/2 x 4-1/2	_____	\$	_____
_____	Old returned		Long 4-1/2 x 5-1/2	_____	\$
63.4'	Ft. 3/4	} Copper	_____	in.	\$
_____			G.I.	_____	Pipe at
_____	_____	C.I.	_____	\$	_____
_____	Nipples	_____	in.	at	\$
_____	Bushings	_____	to	_____	in.
_____	_____	_____	_____	at	\$
_____	Red'g	_____	_____	_____	\$
_____	Inc'g	_____	_____	_____	\$
_____	Union	_____	in.	at	\$
_____	Meter	_____	in.	at	\$
_____	_____	_____	_____	_____	\$
_____	Compound Joints at	_____	_____	_____	\$
_____	Maintenance Foreman	_____	_____	_____	\$
_____	Hrs. Water Maint. Man - 1 at	_____	_____	_____	\$
_____	Hrs. Water Maint. Man - 2 at	_____	_____	_____	\$
_____	Hrs. Garage Foreman	_____	at	_____	\$
_____	Hrs. Labor	_____	at	_____	\$
_____	Hrs. Compressor at	_____	_____	_____	\$
_____	_____	_____	_____	_____	\$
_____	Trucking	_____	_____	_____	\$
_____	Pav't Patch	_____	_____	_____	\$
_____	_____	_____	_____	_____	\$
_____	_____	_____	_____	_____	\$
BOYLSTON

St. 65
Pl. LOT 15
Ave. No.


Name of Owner _____

Labor and Mat'l. Report 19 DEC. 30, 2003

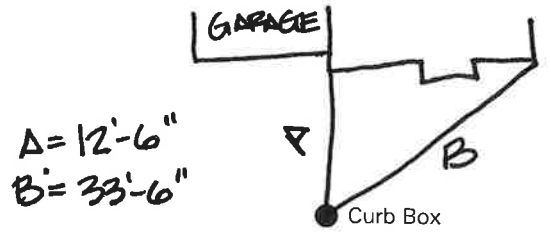

8" Main Elev. of Main at tap 4.75'

Gate at ● Gate at ●

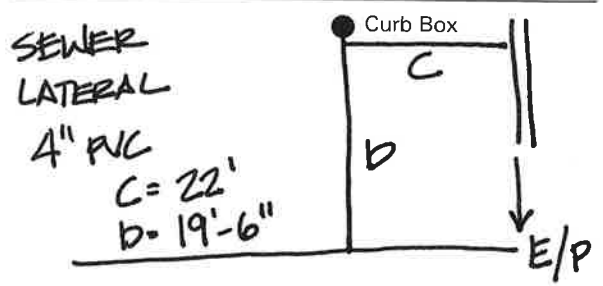

BOYLSTON ST.