

LABOR AND MATERIALS

1	Copper Lead	Connection	<u>3/4 in</u>		\$
1	Curb	Cock Valve T.S. & V.	<u>3/4 in.</u>		\$
1	Service box Old returned	Short $3\frac{1}{2} \times 4\frac{1}{2}$ Long $4\frac{1}{2} \times 5\frac{1}{2}$ Buff or Rdway			\$
25	Ft. <u>3/4</u> in.	Copper G. I. C. I.	Pipe at		\$
	Nipples	in. at			\$
	Bushings	to in. at			\$
	Red'g Inc'g	Coupl'gs to in. at			\$
	Union	in. at			\$
	Meter	in. at			\$
	Lead Joints	at			\$
	Compound Joints	at			\$
	Maintenance Foreman				\$
	Hrs. Water Maint. Man—1	at			\$
	Hrs. Water Maint. Man—2	at			\$
	Hrs. Garage Foreman	at			\$
	Hrs. Labor	at			\$
	Hrs. Compressor	at			\$
	Compensation Ins. at \$	per C			\$
	Trucking				\$
	Pav't Patch				\$
					\$
					\$
	O'head				\$
					\$


W Bolyston

St.
Pl.
Ave. No. 15-17

Name of Owner

Robert Blair

Labor and Mat'l. Report June 19 1977

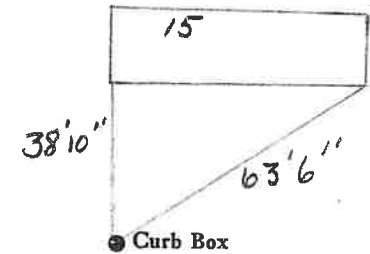

6" Main

Elev. of
Main at tap

Gate at ●

● Gate at

● Curb Box