

LABOR AND MATERIALS

| | | | | | |
|----|-------------------------|-------------------------------|----------------|--|---------|
| 1 | Copper | } Connection | 3/4" | \$ | |
| | Lead | | | | |
| 1 | Curb | } Cock Valve T. S. & V. | 3/4 in. oriser | \$ | |
| 1 | Service box | | | } Short 3 1/2 x 4 1/2 Long 4 1/2 x 5 1/2 Buff or Rdway | 4' x 5' |
| | Old returned | | | | |
| 14 | Ft. | } Copper Pipe | 3/4 in. | \$ | |
| | | | | | |
| | Nipples | in. at | | \$ | |
| | Bushings | to in. at | | \$ | |
| | Red'g | } Coupl'gs | to in. at | \$ | |
| | Inc'g | | | | |
| | Union | in. at | | \$ | |
| | Meter | in. at | | \$ | |
| | Lead Joints | at | | \$ | |
| | Compound Joints | at | | \$ | |
| | Maintenance Foreman | | | \$ | |
| | Hrs. Water Maint. Man-1 | at | | \$ | |
| | Hrs. Water Maint. Man-2 | at | | \$ | |
| | Hrs. Garage Foreman | at | | \$ | |
| | Hrs. Labor | at | | \$ | |
| | Hrs. Compressor | at | | \$ | |
| | Compensation Ins. at \$ | per C | | \$ | |
| | Trucking | | | \$ | |
| | Pav't Patch | | | \$ | |
| | Tap By Purvis & Fosmer | | | \$ | |
| | Oct-15-1976 | | | \$ | |
| | O'head | | | \$ | |

West

Boylston

St.

16


Ave. No. 16

Name of Owner

John Deeb

Labor and Mat'l. Report

Oct. 15 1976

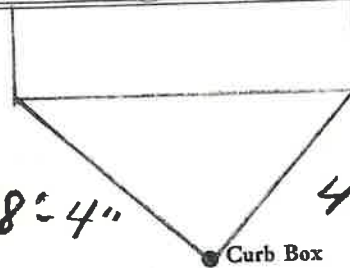

6" Main

Elev. of

Main at tap

Gate at •

• Gate at

• Curb Box