

LABOR AND MATERIALS

1 Copper } Connection  $\frac{1}{2}$ " x  $\frac{3}{4}$ " \$ \_\_\_\_\_  
 Lead }  
 1 Curb } Cock }  $\frac{3}{4}$ " O x i s e a l \$ \_\_\_\_\_  
 } Valve }  
 } T.S. & V. }  
 1 Service box { Short  $3\frac{1}{2}$  x  $4\frac{1}{2}$  } \$ \_\_\_\_\_  
 Old returned { Long  $4\frac{1}{2}$  x  $5\frac{1}{2}$  } \$ \_\_\_\_\_  
 } Buff or Rdway }  
 53 Ft.  $\frac{3}{4}$  in. { Copper } Pipe at \$ \_\_\_\_\_  
 } C.I. }  
 } C.I. }  
 Nipples \_\_\_\_\_ in. at \$ \_\_\_\_\_  
 Bushings \_\_\_\_\_ to \_\_\_\_\_ in. at \$ \_\_\_\_\_  
 Red'g } Coupl'gs \_\_\_\_\_ to \_\_\_\_\_ in. at \$ \_\_\_\_\_  
 Inc'g }  
 Union \_\_\_\_\_ in. at \$ \_\_\_\_\_  
 Meter \_\_\_\_\_ in. at \$ \_\_\_\_\_  
 Lead Joints at \$ \_\_\_\_\_  
 Compound Joints at \$ \_\_\_\_\_  
 Maintenance Foreman \$ \_\_\_\_\_  
 Hrs. Water Maint. Man—1 at \$ \_\_\_\_\_  
 Hrs. Water Maint. Man—2 at \$ \_\_\_\_\_  
 Hrs. Garage Foreman \_\_\_\_\_ at \$ \_\_\_\_\_  
 Hrs. Labor \_\_\_\_\_ at \$ \_\_\_\_\_  
 Hrs. Compressor at \$ \_\_\_\_\_  
 Compensation Ins. at \$ \_\_\_\_\_ per C \$ \_\_\_\_\_  
 Trucking \$ \_\_\_\_\_  
 Pav't Patch \$ \_\_\_\_\_  
 Tap by Donovan \$ \_\_\_\_\_  
 Jarbeau \$ \_\_\_\_\_  
 10-14-64 \$ \_\_\_\_\_  
 O'head \$ \_\_\_\_\_  
 \$ \_\_\_\_\_  
 \$ \_\_\_\_\_

41

Broad Acres


R1  
 St.  
 Pl.  
 Ave. No. 17

Name of Owner

Ornstein

Labor and Mat'l. Report

Oct. 13 1964

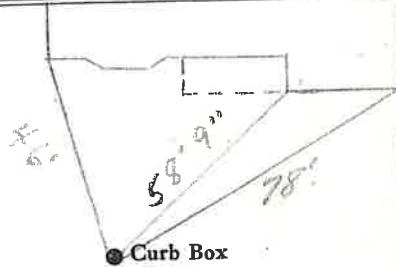

● Curb Box

Broad Acres Rd.  
 2" Galv. Main Elev. of Main at tap 3'

Gate at ●

● Gate at

● Curb Box

This Tap on Broad Acres Rd.

Ashtley Place