

### LABOR AND MATERIALS


Copper	} Connection		\$	
Lead				
Curb	} Cock Valve T. S. & V. }	in.	\$	
Service box Old returned	} Short 3½ x 4½ Long 4½ x 5½ Buff or Rdway }		\$	
Ft. in.	} Copper G. I. C. I. }	Pipe at	\$	
Nipples	in. at		\$	
Bushings	to in. at		\$	
Red'g Inc'g	} Coupl'gs	to in. at	\$	
Union	in. at		\$	
Meter	in. at		\$	
Lead Joints	at		\$	
Compound Joints	at		\$	
Maintenance Foreman			\$	
Hrs. Water Maint. Man-1	at		\$	
Hrs. Water Maint. Man-2	at		\$	
Hrs. Garage Foreman	at		\$	
Hrs. Labor	at		\$	
Hrs. Compressor	at		\$	
Compensation Ins.	at \$ per C		\$	
Trucking			\$	
Pav't Patch			\$	
			\$	
			\$	
			\$	
O'head			\$	
			\$	

2/23/81

St. \_\_\_\_\_  
Pt. \_\_\_\_\_  
Ave. No. 19

Name of Owner \_\_\_\_\_

Labor and Mat'l. Report 19

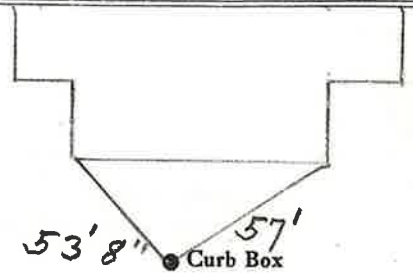

	Elev. of
Main	Main at tap
Gate at •	• Gate at

**NEW MEASUREMENTS** • Curb Box