

LABOR AND MATERIALS

Copper	}	Connection		\$	
Lead					
Curb	}	Cock	} in.	\$	
		Valve			
		T. S. & V.			
Service box Old returned	}	Short 3½ x 4½	} _____	\$	
		Long 4½ x 5½			
		Buff or Rdway			
Ft. _____ in.	}	Copper	} Pipe at _____	\$	
		G. I.			
		C. I.			
Nipples	in.	at		\$	
Bushings	to	in.	at		\$
Red'g Inc'g	}	Coupl'gs	to _____ in.	at _____	\$
Union	in.	at		\$	
Meter	in.	at		\$	
Lead Joints	at			\$	
Compound Joints	at			\$	
Maintenance Foreman				\$	
Hrs. Water Maint. Man—1	at			\$	
Hrs. Water Maint. Man—2	at			\$	
Hrs. Garage Foreman	at			\$	
Hrs. Labor	at			\$	
Hrs. Compressor	at			\$	
Compensation Ins.	at \$ _____ per C			\$	
Trucking				\$	
Pav't Patch				\$	
				\$	
				\$	
				\$	
O'head				\$	
				\$	


St. Pl. Ave. No. 20

BROADACRES ROAD

Name of Owner _____

Labor and Mat'l. Report

19

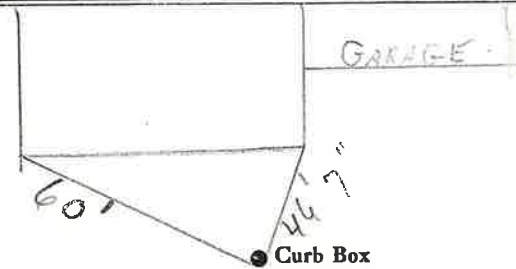

Main Elev. of Main at tap _____

Gate at • • Gate at

• Curb Box

REMEASURED
2/19/81