

# LABOR AND MATERIALS


3/4 Copper } Connection \_\_\_\_\_ \$ \_\_\_\_\_  
 Lead }  
 Curb } Cock Valve } \_\_\_\_\_ in. \_\_\_\_\_ \$ \_\_\_\_\_  
 } T.S. & V. }  
 Service box { Short 3-1/2 x 4-1/2 } \_\_\_\_\_ \$ \_\_\_\_\_  
 Old returned { Long 4-1/2 x 5-1/2 } \_\_\_\_\_ \$ \_\_\_\_\_  
 15 Ft. 3/4 in. { Copper } Pipe at \_\_\_\_\_ \$ \_\_\_\_\_  
 } G.I. }  
 } C.I. }  
 Nipples \_\_\_\_\_ in. at \_\_\_\_\_ \$ \_\_\_\_\_  
 Bushings \_\_\_\_\_ to \_\_\_\_\_ in. at \_\_\_\_\_ \$ \_\_\_\_\_  
 Red'g \_\_\_\_\_  
 Inc'g \_\_\_\_\_  
 Union \_\_\_\_\_ in. at \_\_\_\_\_ \$ \_\_\_\_\_  
 Meter \_\_\_\_\_ in. at \_\_\_\_\_ \$ \_\_\_\_\_  
 \_\_\_\_\_ \$ \_\_\_\_\_  
 Compound Joints at \_\_\_\_\_ \$ \_\_\_\_\_  
 Maintenance Foreman \_\_\_\_\_ \$ \_\_\_\_\_  
 Hrs. Water Maint. Man - 1 at \_\_\_\_\_ \$ \_\_\_\_\_  
 Hrs. Water Maint. Man - 2 at \_\_\_\_\_ \$ \_\_\_\_\_  
 Hrs. Garage Foreman \_\_\_\_\_ at \_\_\_\_\_ \$ \_\_\_\_\_  
 Hrs. Labor \_\_\_\_\_ at \_\_\_\_\_ \$ \_\_\_\_\_  
 Hrs. Compressor at \_\_\_\_\_ \$ \_\_\_\_\_  
 \_\_\_\_\_ \$ \_\_\_\_\_  
 Trucking \_\_\_\_\_ \$ \_\_\_\_\_  
 Pav't Patch \_\_\_\_\_ \$ \_\_\_\_\_  
 \_\_\_\_\_ \$ \_\_\_\_\_  
 \_\_\_\_\_ \$ \_\_\_\_\_  
Bush

St. Pl. Ave. No. 10

Name of Owner

Labor and Mat'l. Report 5-18-07

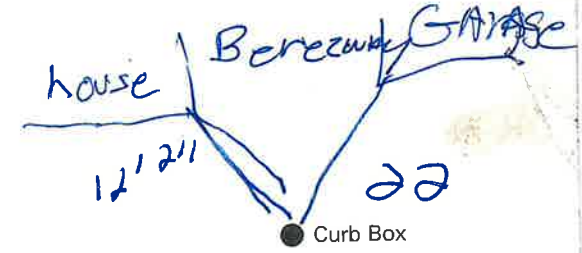

6" Main

Elev. of Main at tap 5' 6"

Gate at ●

● Gate at

● Curb Box


LABOR AND MATERIALS

Copper	} Connection		\$
Lead			
Curb	} in.	Cock	\$
		Valve	\$
		T. S. & V.	\$
Service box	} Short 3½ x 4½		\$
Old returned		Long 4½ x 5½	\$
		Buff or Rdway	\$
Ft. in.	} Pipe at	Copper	\$
		G. I.	\$
Nipples	in. at		\$
Bushings	to in. at		\$
Red'g	} Coupl'gs. to in. at		\$
Inc'g			\$
Union	in. at		\$
Meter	in. at		\$
Lead Joints	at		\$
Compound Joints	at		\$
Maintenance Foreman			\$
Hrs. Water Maint. Man	1 at		\$
Hrs. Water Maint. Man	2 at		\$
Hrs. Garage Foreman	at		\$
Hrs. Labor	at		\$
Hrs. Compressor	at		\$
Compensation Ins.	at \$ per C		\$
Trucking			\$
Pav't Patch			\$
			\$
			\$
			\$
O'head			\$
			\$

N. E. CORNER  
 Woodward + St. Pt. Ave. No. 51

Name of Owner Bush St. Forrest Wallace.

Measured 117  
 Labor and Mat'l. Report Feb. 3 1959

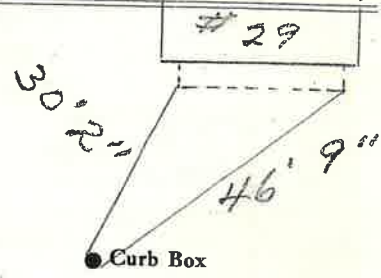

6 Main Elev. of Main at tap 5'  
 Gate at • Gate at •

This Tap Measured from Curb Box 29 Woodward St. For house on Bush St.