

LABOR AND MATERIALS


Copper	}	Connection		\$		
Lead						
Curb	}	Cock	in.	\$		
		Valve				
		T. S. & V.				
Service box Old returned	}	Short 3½ x 4½		\$		
		Long 4½ x 5½				
		Buff or Rdway				
Ft.	}	in.	Pipe at	\$		
		Copper				
		C.I.				
Nipples	in.	at	\$			
Bushings	to	in.	at	\$		
Red'g Inc'g	}	Coupl'gs	to	in.	at	\$
Union	in.	at	\$			
Meter	in.	at	\$			
Lead Joints	at	\$				
Compound Joints	at	\$				
Maintenance Foreman		\$				
Hrs. Water Maint. Man-1	at	\$				
Hrs. Water Maint. Man-2	at	\$				
Hrs. Garage Foreman	at	\$				
Hrs. Labor	at	\$				
Hrs. Compressor	at	\$				
Compensation Ins. at \$	per C	\$				
Trucking		\$				
Pav't Patch		\$				
		\$				
		\$				
		\$				
O'head		\$				
		\$				

Bush

St.
Pt. 54
Ave. No.

Name of Owner
Peteis

Labor and Mat'l. Report 19

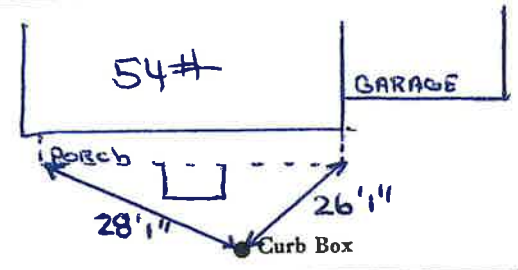

6 Main Elev. of Main at tap 5''

Gate at ● ● Gate at

● Curb Box

