

LABOR AND MATERIALS


~~1~~ Copper Connection $\frac{3}{4}$ " \$
~~1~~ Lead \$
~~1~~ Curb { Cock Valve } $\frac{3}{4}$ in. 971 \$ 7.43
 { T. S. & V. }
 1 Service box { Short $3\frac{1}{2} \times 4\frac{1}{2}$ }
 19 Old returned { Long $4\frac{1}{2} \times 5\frac{1}{2}$ }
 { Buffer Rdway } \$
~~5~~ Ft. $\frac{3}{4}$ in. { Copper } Pipe at 30 \$ 1.50
 { G. I. }
 { C. I. }
~~1~~ Nipples $\frac{1}{4}$ in. at 6" heavy \$ 25
~~1~~ Bushings $\frac{3}{4}$ to Nip in. at 5" \$ 12
 Red'g |
 Inc'g | Coupl'gs to in. at \$
~~1~~ Union $\frac{1}{4}$ in. at \$ 1.10
~~1~~ Meter $\frac{1}{4}$ in. at T. S. $\frac{3}{4}$ \$ 29
 Lead Joints at \$
 Compound Joints at \$
 Hrs. Water Maint. Man—1 at \$
~~3~~ Hrs. Water Maint. Man—2 at 102 \$ 306
~~14~~ Hrs. Labor— at 91 \$ 12.74
 Hrs. Labor— at \$
 Hrs. Compressor at \$
 Compensation Ins. at \$ per C. \$ 35
 Trucking \$ 1
 Pav't Patch \$
 Tap by ~~Michigan~~ \$
 O'head \$
 $\frac{3}{4}$ " Renewal Tap. \$ 25.20
 1-20-68. by Lareau + Co.

142-1948

St. _____
 Pl. _____
 Ave. No. 59

Name of Owner
 King (Albert)

Labor and Mat'l. Report Oct 5 1948

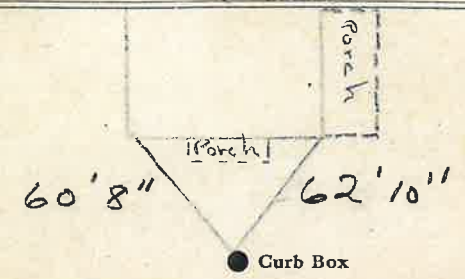

6" Main
 Elev. of Main at tap 3'

Gate at ● Gate at ●
 19' to MBIN

● Curb Box
 Tap on Side of
 Main, Service
 Pipe Down about
 4'