

LABOR AND MATERIALS

Copper Lead	} Connection	$\frac{3}{4}$		\$ 2.94
Curb	{ Clock Valve T. S. & V. }	$\frac{3}{4}$ in.		\$ 3.71
Service box Old returned	{ Short $3\frac{1}{2} \times 4\frac{1}{2}$ Long $4\frac{1}{2} \times 5\frac{1}{2}$ Buff or Rdway }			\$ 5.90
25 ²⁶ Ft. $\frac{3}{4}$ in.	{ Copper Galv. Iron Cast Iron }		Pipe at 30	\$ 7.50
Nipples	in. at			\$
Bushings	to in. at			\$
Red'g Inc'g	{ Couplings	to in. at		\$
Union	in. at			\$
Meter	in. at			\$
Lead Joints	at			\$
Compound Joints	at			\$
Hrs. Foreman	at			\$
6 Hrs. Chauffeur	at	WMM-2	91	\$ 5.46 ^{11.92}
Hrs. Taper	at			\$
8 Hrs. Labor	at		80	\$ 6.40
Hrs. Labor	at			\$
Hrs. Compressor	at			\$
Compensation Ins.				\$ 26
Trucking				\$ 1.00
Builders Use of Water				\$
Tap by Mansfield				\$
				\$
				\$
				\$
				\$
				\$ 33.17

6 - 1948

Bush


St. Pt. Ave. No. 62

Name of Owner

Walter McEachron

Labor and Mat'l. Report

Feb 7 1948

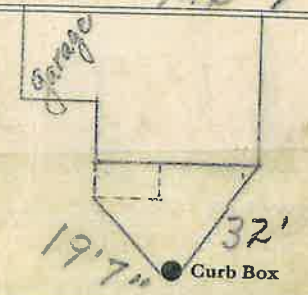

6" Main
4 1/4" Main
Elev. of Main at tap 4-5'

Gate at ● Gate at ●

● Curb Box

SHUT OFF AT CURB -
1992

LABOR AND MATERIALS

Copper	}	Connection		\$	
Lead					
Curb	}	Cock	} in.	\$	
		Valve			
		T. S. & V.			
Service box	}	Short $3\frac{1}{2} \times 4\frac{1}{2}$	}	\$	
Old returned		Long $4\frac{1}{2} \times 5\frac{1}{2}$			
Ft. $\frac{3}{4}$ in.	}	Copper	} Pipe at	\$	
		C.T.			
Nipples		in. at		\$	
Bushings		to in. at		\$	
Red'g	}	Coupl'gs	to in. at	\$	
Inc'g					
Union		in. at		\$	
Meter		in. at		\$	
				\$	
Compound Joints		at		\$	
Maintenance Foreman				\$	
Hrs. Water Maint. Man—1		at		\$	
Hrs. Water Maint. Man—2		at		\$	
Hrs. Garage Foreman		at		\$	
Hrs. Labor—		at		\$	
Hrs. Compressor		at		\$	
				\$	
Trucking				\$	
Pav't Patch				\$	
				\$	
				\$	
				\$	
				\$	

BUSH

St.
Pl.
Ave. No. 62

Name of Owner

Labor and Mat'l. Report

19 92

