

### Labor and Materials

Copper	Connection	\$	
Lead			
2 Curb	Cock Valve 7-8. or 4. } 3/4 in @ 1.65	\$	3.30
2 Service Box	Short 3 1/2 x 4 1/2	}	1.75 \$ 3.50
Old returned	Long 4 1/2 x 5 1/2		
	Buff. or Rdway.		
15 Ft. 3/4 in.	Copper Pipe at	15	2.25
	Cast-iron		
Nipples	in. at		
Bushings	to in. at		
Red's Inc's	Conplings to in. at		
1 Union 1/4 in.	at		.36
Meter	in. at		
Lead Joints	at		
Leadite Joints	at		
Hrs. Foreman	at		
9 Hrs. Chauffeur	at 6 1/2 hr		5.63
12 Hrs. Tapper	at 4		7.50
12 Hrs. Labor	at		6.40
Hrs. Labor	at		
Hrs. Compressor	at		
Compensation Ins.			.57
Trucking			1
Builders Use of Water	(no patch)		
1 - 1/4 x 3/4 T-branch			.28
1 - 1/4" gate valve			2.13
1 - 3/4" short nipple			.01
1 - 1/4" nipple 6" long			.12
1 - 1/4" short			.10
1 - Copper to iron connection 3/4"			.32
Total by Remond & Hassell			33.36

33 - 1938

St.   
 Pl.   
 Ave. No.

Flush


Name of Owner

Drake

Labor and Mat'l. Report

June 16

1938

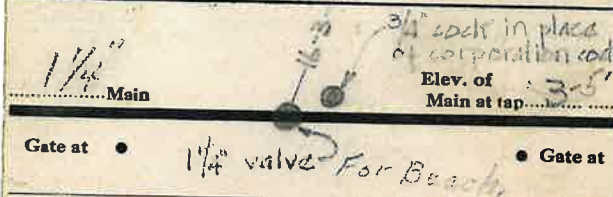

● Carb Box

This Tap off 1 1/4" Beach Line, Ahead of Beach shut off. 1" Tap for Beach is between gate & Hydt. ON END OF MAIN.