

# LABOR AND MATERIALS

Copper	Lead	Connection	3/4	\$	2.87
Curb	Valve	Cock	3/4 in.	\$	3.62
Service box	Old returned	Short 3 1/2 X 4 1/2		\$	4.68
		Long 4 1/2 X 5 1/2		\$	
		Buff or Rdway		\$	
22 Ft.	3/4 in.	Copper	Pipe at 37	\$	7.04
		G.I.		\$	
		C.I.		\$	
Nipples	in.	at		\$	
Bushings	to	in.	at	\$	
Red'g				\$	
Inc'g	Coupl'gs	to	in.	at	\$
Union	in.	at		\$	
Meter	in.	at		\$	
Lead Joints	at			\$	
Compound Joints	at			\$	
3	Hrs. Water Maint. Man-1	at 1.17		\$	3.36
1	Hrs. Water Maint. Man-2	at 1.07		\$	3.06
9	Hrs. Labor	at 91		\$	8.19
	Hrs. Labor	at		\$	
	Hrs. Compressor	at		\$	
	Compensation Ins.	at \$2.18 per C		\$	37
	Trucking			\$	2.00
	Pav't Patch			\$	10.75
	Tap by Miller			\$	
	O'head			\$	
				\$	45.39

13-1949

St. \_\_\_\_\_  
Pl. \_\_\_\_\_  
Ave. No. 19


Bush St

Name of Owner

Peters (Henry)

Labor and Mat'l. Report

April 8 1949

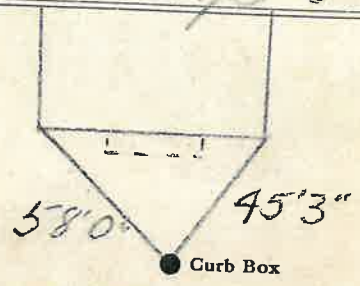


6 Main

Elev. of Main at tap 4 1/2

Gate at ●

● Gate at

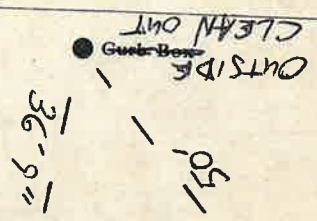

6/1 #