

LABOR AND MATERIALS

1	Copper Lead	Connection	3/4"	\$	2.71
1	Curb	Cock Valve T.S. & V.	3/4 in.	\$	3.83
1	Service box	Short 3 1/2 x 4 1/2		\$	4.69
	Old returned	Long 4 1/2 x 5 1/2		\$	
		Buff or Rdway		\$	
17	Ft. 3/4 in.	Copper C.I. C.I.	Pipe at 45	\$	7.20
	Nipples	in. at		\$	
	Bushings	to in. at		\$	
	Red'g Inc'g	Coupl'gs to in. at		\$	
	Union	in. at		\$	
	Meter	in. at		\$	
	Lead Joints	at		\$	
	Compound Joints	at		\$	
	Maintenance Foreman			\$	49.00
	Hrs. Water Maint. Man-1	at		\$	
14	Hrs. Water Maint. Man-2	at 1.24		\$	17.36
	Hrs. Garage Foreman	at		\$	
28	Hrs. Labor	at 1.13		\$	31.64
	Hrs. Compressor	at		\$	
	Compensation Ins.	at \$ 4.29 per C.		\$	2.10
	Trucking			\$	1.50
	Pav't Patch			\$	14.85
	Tap by Giffard			\$	
	7-7-55			\$	
	O'head			\$	
				\$	85.88


71.03

Tap # 69-1955

Bush St. -Pr Ave. No. 25

Name of Owner Weller

Labor and Mat'l. Report July 7 1955

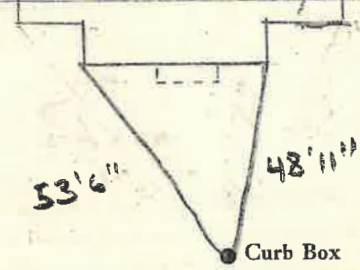

6 Main Elev. of Main at tap 4 1/2

Gate at • Gate at

TAX ID #309.15-8-20

• Curb Box