

LABOR AND MATERIALS

1. Copper / Lead	Connection	3/4	\$	2.87
1. Curb	Cock Valve	3/4 in.	\$	3.62
1. Service box	Short 3 1/2 X 4 1/2			
Old returned	Long 4 1/2 X 5 1/2			
	Buff or Rdway		\$	4.68
11. Ft. 3/4 in.	Copper Pipe at	32	\$	3.52
	Nipples	in. at	\$	
	Bushings	to in. at	\$	
	Red'g Inc'g	Coupl'gs to in. at	\$	
	Union	in. at	\$	
	Meter	in. at	\$	
	Lead Joints	at	\$	
	Compound Joints	at	\$	
	Hrs. Water Maint. Man-1	at	\$	
12	Hrs. Water Maint. Man-2	at 1.02	\$	12.24
25	Hrs. Labor-	at 91	\$	22.75
	Hrs. Labor-	at	\$	
	Hrs. Compressor	at	\$	
	Compensation Ins.	at \$2.18 per C	\$	7.6
	Trucking		\$	2.90
	Pav't Patch		\$	10.25
	Tax by 12/22/49		\$	
	O'head		\$	
			\$	62.69

105-194-9

Bush


St. Pt. Ave. No. 41

Name of Owner

Warner

Labor and Mat'l. Report

Sept 29 19 49

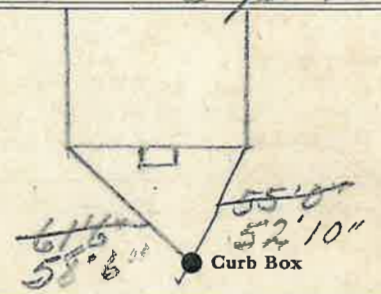

6 Main

Elev. of Main at tap 4

Gate at ● Gate at

11' to MAIN

● Curb Box

TAX ID # 309.15-8-9