


LABOR AND MATERIALS

Copper	} Connection		\$
Lead			
Curb	} Clock Valve T. S. & V. }	in.	\$
Service box			
Old returned	} Short 3 1/2 X 4 1/2 } Long 4 1/2 X 5 1/2 } Buff or Rdway }		\$
Ft.	} Copper Galv. Iron Cast Iron }	Pipe at	\$
in.			
Nipples	in. at		\$
Bushings	to in. at		\$
Red'g Inc'g	} Couplings	to in. at	\$
Union	in. at		\$
Meter	in. at		\$
Lead Joints at			\$
Compound Joints at			\$
Hrs. Foreman at			\$
Hrs. Chauffeur at			\$
Hrs. Tapper at			\$
Hrs. Labor at			\$
Hrs. Labor at			\$
Hrs. Compressor at			\$
Compensation Ins.			\$
Trucking			\$
Builders Use of Water			\$
<i>Message by Marsuaker & Geo</i>			
			\$
			\$
			\$
			\$

Bynne Ave St. *23*
Pl. Ave. No. *15*

Name of Owner _____
Labor and Mat'l. Report *Dress* 19*25*

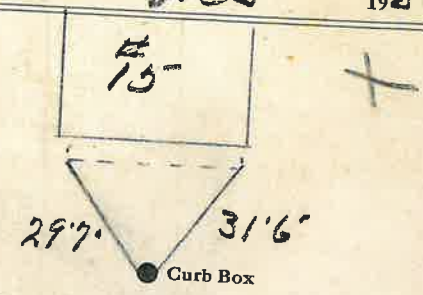

12" Main Elev. of Main at tap _____
Gate at ● Gate at ●

● Curb Box