

LABOR AND MATERIALS

1	Copper	} Connection	3/4"	\$	_____		
1	Lead						
1	Curb	} Cock Valve T.S. & V.	} 3/4" in.	\$	_____		
1	Service box			} Short 3 1/2 x 4 1/2	}	\$	_____
	Old returned					} Long 4 1/2 x 5 1/2	}
			Buff or Rdway				
26	Ft. 3/4 in.	} Copper	} Pipe at	\$	_____		
				} G.I.	}	\$	_____
		} G.I.	}			\$	_____
	Nipples				in. at	\$	_____
	Bushings		to in. at	\$	_____		
	Red'g Inc'g	} Coupl'gs	} to in. at	\$	_____		
						\$	_____
	Union		in. at	\$	_____		
	Meter		in. at	\$	_____		
	Lead Joints		at	\$	_____		
	Compound Joints		at	\$	_____		
	Maintenance Foreman			\$	_____		
	Hrs. Water Maint. Man	1	at	\$	_____		
	Hrs. Water Maint. Man	2	at	\$	_____		
	Hrs. Garage Foreman		at	\$	_____		
	Hrs. Labor		at	\$	_____		
	Hrs. Compressor		at	\$	_____		
	Compensation Ins.		at \$ _____ per C.	\$	_____		
	Trucking			\$	_____		
	Pav't Patch			\$	_____		
	Tap		April 4, 1977	\$	_____		
			Reocch + Co.	\$	_____		
	O'head			\$	_____		

Byrne


St. Pl. Ave. No. 24

Name of Owner

E. F. Crandall

Labor and Mat'l. Report

April 1 19 77

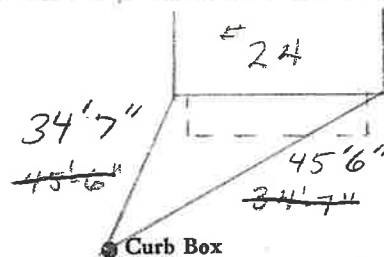

12" Main

Elev. of Main at tap 3'

Gate at ●

● Gate at

● Curb Box

(HAS)
 Sewer out side clean
 out 4/9/07 BY WATER
 JUST TO THE RIGHT SIDE
 BY ROAD