


LABOR AND MATERIALS

1	Copper	} Connection	3/4"	\$	
	<del>Lead</del>				
1	Curb	} Cock Valve T.S. & V.	} 3/4" in.	\$	
1	Service box			} Short 3 1/2 x 4 1/2	\$
	Old returned				
8	Ft.	} Copper C.P. Curb	} 3/4" in.	Pipe at \$	
	Nipples			in. at \$	
	Bushings	to in. at \$			
	Red'g Ino'g	} Coupl'gs	to in. at \$		
	Union			in. at \$	
	Meter	in. at \$			
	Compound Joints	at \$			
	Maintenance Foreman	\$			
	Hrs. Water Maint. Man—1	at \$			
	Hrs. Water Maint. Man—2	at \$			
	Hrs. Garage Foreman	at \$			
	Hrs. Labor—	at \$			
	Hrs. Compressor	at \$			
	Trucking	\$			
	Pav't Patch	\$			
		\$			
		\$			
BYRNE St. PL Ave. No. 292

Name of Owner Labor and Mat'l. Report MAY 19 30

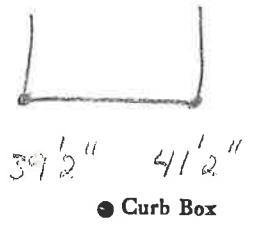

12" Main Elev. of Main at tap 4'

Gate at ● Gate at

● Curb Box