

LABOR AND MATERIALS


1	Copper	} Connection	3/4"	\$	
	Lead				
1	Curb	} Cock	3/4 in. Oriscal	\$	
					} Valve
		T. S. & V.			
1	Service box	} {	Short 3 1/2 x 4 1/2	\$	
	<del>Old returned</del>				} Long 4 1/2 x 5 1/2
26	Ft. 3/4 in.	} {	Copper	Pipe at	
					} G. I.
	Nipples	in. at	\$		
	Bushings	to in. at	\$		
	Red'g	} Coupl'gs	to in. at	\$	
	Inc'g				
	Union	in. at	\$		
	Meter	in. at	\$		
	Lead Joints	at	\$		
	Compound Joints	at	\$		
	Maintenance Foreman		\$		
	Hrs. Water Maint. Man-1	at	\$		
	Hrs. Water Maint. Man-2	at	\$		
	Hrs. Garage Foreman	at	\$		
	Hrs. Labor	at	\$		
	Hrs. Compressor	at	\$		
	Compensation Ins. at \$	per C	\$		
	Trucking		\$		
	Pav't Patch		\$		
	Tap by Gifford & Co.		\$		
	11-3-67.		\$		
	O'head		\$		
			\$		

St. \_\_\_\_\_  
 Pl. \_\_\_\_\_  
 Ave. No. 38

Byrne  
 Name of Owner

Payment

Labor and Mat'l. Report Nov. 3 1967

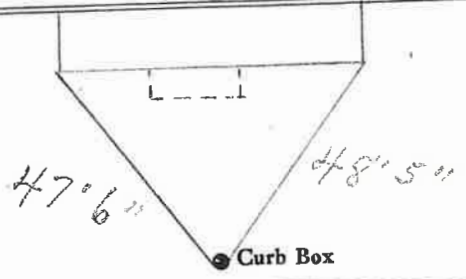

12" Main Elev. of Main at tap 7'

Gate at • Gate at •

TAX ID # 303.13-4-3

• Curb Box