

LABOR AND MATERIALS

1	Copper Lead	Connection	3/4"	\$	2.71
1	Curb	Cock Valve - T.S. & V.	3/4 in.	\$	3.83
1	Service box Old returned	Short 3 1/2 x 4 1/2 Long 4 1/2 x 5 1/2 Buff or Rdway		\$	4.69
27	Ft. 3/4 in.	Copper G.I. C.I.	Pipe at	45	\$12.15
	Nipples	in. at		\$	
	Bushings	to in. at		\$	
	Red'g Inc'g	Coupl'gs to in. at		\$	
	Union	in. at		\$	
	Meter	in. at		\$	
	Lead Joints at			\$	
	Compound Joints at			\$	
	Maintenance Foreman			\$	
	Hrs. Water Maint. Man-1 at			\$	
9	Hrs. Water Maint. Man-2 at	1.24		\$	11.16
	Hrs. Garage Foreman at			\$	
8	Hrs. Labor at	1.13		\$	9.04
	Hrs. Compressor at			\$	
	Compensation Ins. at \$	4.29 per C		\$	87
	Trucking			\$	1.50
	Pav't Patch	64T.		\$	
	Tap by Gifford			\$	
		9-9-55		\$	
	O'head			\$	
				\$	45.95

St. 44  
Pl.  
Ave. No. 46


Byline

Name of Owner

Barker

Labor and Mat'l. Report

Sept. 9, 1955

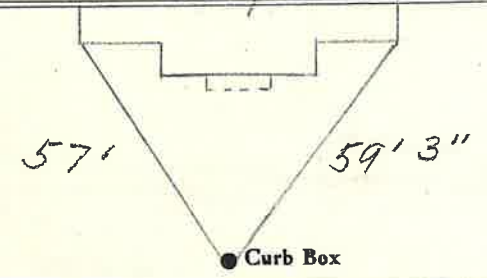

12" Main

Elev. of Main at tap 5 1/2'

Gate at ●

● Gate at

● Curb Box