

LABOR AND MATERIALS

1	Copper Lead	Connection	$\frac{3}{4}$		\$ 159.
1	Curb	Clock Valve T.S. & V.	$\frac{3}{4}$	in.	\$ 2.74
1	Service box Old returned	Short $3\frac{1}{2} \times 4\frac{1}{2}$ Long $4\frac{1}{2} \times 5\frac{1}{2}$ Buff or Rdway	Same		\$ —
10	Ft.	$\frac{3}{4}$ in.	Copper Galv. Iron Cast-iron	Pipe at 19	\$ 1.90
	Nipples	in. at			\$
	Bushings	to in. at			\$
	Red'g Inc'g	Couplings	to in. at		\$
	Union	in. at			\$
	Meter	in. at			\$
	Lead Joints	at			\$
	Compound Joints	at			\$
5	Hrs. Foreman at	W.W.M. @ .24			\$ 4.20
3	Hrs. Chauffeur at	.75			\$ 2.25
5	Hrs. Tapper at	.75			\$ 3.75
12	Hrs. Labor at	.65			\$ 7.80
	Hrs. Labor at				\$
	Hrs. Compressor at				\$
	Compensation Ins.				\$.53
	Trucking				\$ 1.50
	Builders Use of Water	Patch			\$ 5.00
	Tap by Maguire,				\$
					\$
					\$
					\$
					\$
					\$ 29.96

15-45

Byrne

St. 11
Pl. 5
Ave. No. 5


Name of Owner

Collins

Labor and Mat'l. Report

Nov 29

19 45

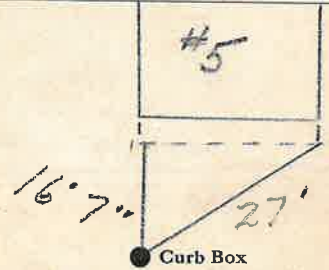

6"12" Main

Elev. of Main at tap 5

Gate at ●

● Gate at


● Curb Box

LABOR AND MATERIALS

Copper } Connection _____ \$ _____
 Lead }
 Curb } Cock _____ in. _____ \$ _____
 Valve }
 T.S. & V. }
 Service box { Short 3-1/2 x 4-1/2 } _____ \$ _____
 Old returned { Long 4-1/2 x 5-1/2 }
 Ft. _____ in. { Copper } Pipe at _____ \$ _____
 { G.I. }
 { C.I. }
 Nipples _____ in. at _____ \$ _____
 Bushings _____ to _____ in. at _____ \$ _____
 Red'g _____
 Inc'g _____
 Union _____ in. at _____ \$ _____
 Meter _____ in. at _____ \$ _____
 _____ \$ _____
 Compound Joints at _____ \$ _____
 Maintenance Foreman _____ \$ _____
 Hrs. Water Maint. Man - 1 at _____ \$ _____
 Hrs. Water Maint. Man - 2 at _____ \$ _____
 Hrs. Garage Foreman _____ at _____ \$ _____
 Hrs. Labor _____ at _____ \$ _____
 Hrs. Compressor at _____ \$ _____
 _____ \$ _____
 Trucking _____ \$ _____
 Pav't Patch _____ \$ _____
 _____ \$ _____
 _____ \$ _____
St. _____
 Pl. _____
 Ave. No. 11
Byrne
 Name of Owner _____

Labor and Mat'l. Report ~~to~~ No Date

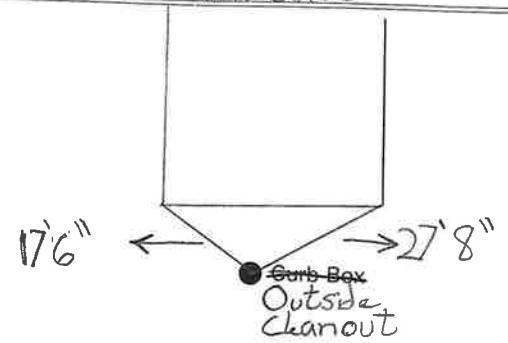

_____ Main
 Elev. of Main at tap _____
 Gate at ● _____ ● Gate at _____

● Curb Box
Outside Clean out