

LABOR AND MATERIALS

1	Copper Lead	} Connection Cock Valve T.S. & V.	3/4 in.	\$
1	Curb			\$
1	Service box Old returned	} Short 3 1/2 x 4 1/2 Long 4 1/2 x 5 1/2		\$
29	Ft. 3/4 in.		} Copper C.I. C.I.	Pipe at
	Nipples	in. at		\$
	Bushings	to in. at	\$	
	Red'g Inc'g	} Coupl'gs	to in. at	\$
	Union		in. at	\$
	Meter	in. at	\$	
	Compound Joints	at	\$	
	Maintenance Foreman		\$	
	Hrs. Water Maint. Man-1	at	\$	
	Hrs. Water Maint. Man-2	at	\$	
	Hrs. Garage Foreman	at	\$	
	Hrs. Labor	at	\$	
	Hrs. Compressor	at	\$	
	Trucking		\$	
	Pav't Patch		\$	
			\$	
			\$	

BYRNE

St. Pt. Ave. No. 14

Name of Owner

Labor and Mat'l. Report

JUNE 19 38

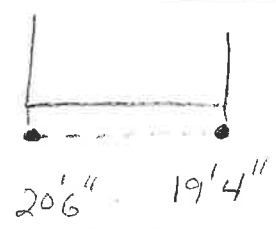

● Curb Box

12" Main

Elev. of Main at tap 51

Gate at ●

● Gate at

● Curb Box