


Labor and Materials

1	Copper	Lead	Connection.....	\$	
1	Curb	Cock Valve T.S.&V.in	\$	
			Service Box { Short 3 1/2 x 4 1/2 Old returned { Long 4 1/2 x 5 1/2 Buff. or Rdway }	\$	
26		3/4"	Copper Galv. Iron Cast Iron } Pipe at	\$	
			Nipplesin. at	\$	
			Bushingstoin. at	\$	
			Red'g Inc'g } Couplings.....to.....in. at	\$	
			Union.....in. at	\$	
			Meter.....in. at	\$	
			Lbs. Br. Stone at	\$	
			Lbs. Sand at	\$	
			Bags Cement at	\$	
			Paving Brick { Mack Red Asphalt } at	\$	
			Lead Joints at	\$	
			Leadite Joints at	\$	
			Hrs. Foreman at	\$	
			Hrs. Common Labor at	\$	
			Hrs. Common Labor at	\$	
			Hrs. Mason at	\$	
			Hrs. Masons Helper at	\$	
			Hrs. Compressor at	\$	
			Compensation Ins	\$	
			Trucking	\$	
			Builders Use of Water	\$	
Total \$.....					

Labor and Material Report

1922

Byrne Ave - No 11 (McLaughlin)

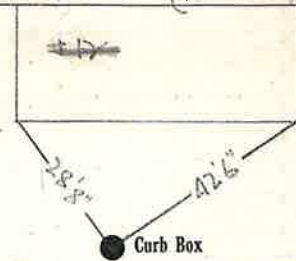

12" Main

Elev. of Main at tap

Gate at ●

● Gate at

● Curb Box