

LABOR AND MATERIALS

1 Copper Lead	Connection	3/4"		\$
1 Curb	Cock Valve	3/4 in.	Orissal	\$
1 Same	T.S. & V.			
1 Service box	Short 3 1/2 x 4 1/2 Long 4 1/2 x 5 1/2 Buff. or Rdway			\$
1 Old returned				
20 Ft.	3/4 in.	Copper C.I. C.I.	Pipe at	\$
	Nipples	in. at		\$
	Bushings	to in. at		\$
	Red'g Inc'g	Coupl'gs	to in. at	\$
	Union		in. at	\$
	Meter	in. at		\$
	Lead Joints at			\$
	Compound Joints at			\$
	Maintenance Foreman			\$
	Hrs. Water Maint. Man-1	at		\$
	Hrs. Water Maint. Man-2	at		\$
	Hrs. Garage Foreman	at		\$
	Hrs. Labor	at		\$
	Hrs. Compressor at			\$
	Compensation Ins. at \$	per C		\$
	Trucking			\$
	Pav't Patch			\$
	Tap by Gifford + Co.			\$
				\$
				\$
	O'head			\$

Center


St. 22A+B
Pl. 22A+B
Ave. No.

Name of Owner

Quinn

Labor and Mat'l. Report

June 16 1965

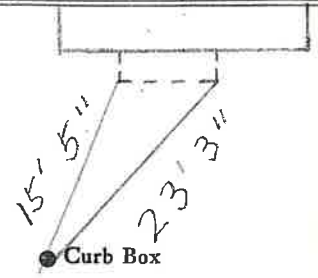

Galv. Center St

14" Main

Elev. of Main at tap

Gate at ●

● Gate at

Tap on Center St.

● Curb Box

See Card for

121 Maple St.