


LABOR AND MATERIALS

1	Copper Lead	Connection	$\frac{3}{4}$ Brass Fills	\$ 50
1	Curb	Cock Valve T. S. & V.	$\frac{3}{4}$ in.	\$ 1.80
1	Service Box Old returned	Short $3\frac{1}{2} \times 4\frac{1}{4}$ Long $4\frac{1}{2} \times 5\frac{1}{4}$ Buff for Rdway		\$ 1.82
8	Ft.	$\frac{3}{4}$ in.	Copper Galv. Iron Cast Iron	Tube Pipe at \$ 1.44
	Nipples	in. at		\$
	Bushings	to in. at		\$
2	Red Inc's	Couplings	in. at	\$ 30
	Union	in. at		\$
	Meter	in. at		\$
	Lead Joints	at		\$
	Leadite Joints	at		\$
	Hrs. Foreman	at		\$
	Hrs. Chauffeur	at		\$
8	Hrs. Tapper	at	68.74	\$ 5.50
9	Hrs. Labor	at	60	\$ 4.80
	Hrs. Labor	at		\$
1	Hrs. Compressor	at	87 1/2	\$ .88
	Compensation Ins.		2.23	\$ .23
	Trucking			\$ 1.00
	Builders Use of Water	Patch		\$ 5.85
	Taylor Hessel			\$
				\$
				\$
				\$ 24.17

7-43  
Center  
St. 9  
Ave. No. 5

Name of Owner  
Foley

Labor and Mat'l. Report May 4 1943

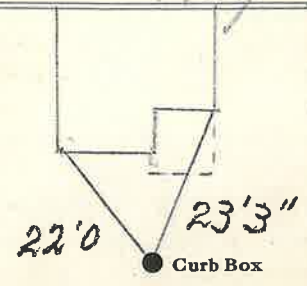

4" Gal Main  
Elev. of Main at tap 6  
Gate at ● Gate at ●

● Curb Box