

LABOR AND MATERIALS


1	Copper	{ Connection	3/4"		\$ 2.29
	Lead				
1	Curb	{ Cock Valve	3/4" in.		\$ 2.70
		{ F.S. & V.			
1	Service box	{ Short 3 1/2 x 4 1/2 Long 4 1/2 x 5 1/2 Buff or Rdway			\$ 4.25
	Old returned				
17	Ft.	{ Copper	3/4 in.	Pipe at 35	\$ 5.95
		{ C.I.			
		{ C.I.			
	Nipples	in. at			\$
	Bushings	to in. at			\$
	Red'g	{ Coupl'gs	to in. at		\$
	Inc'g				
	Union	in. at			\$
	Meter	in. at			\$
	Lead Joints at				\$
	Compound Joints at				\$
1 1/2	Hrs. Water Maint. Man-1	at	1.12		\$ 1.68
3 1/2	Hrs. Water Maint. Man-2	at	1.02		\$ 3.57
7	Hrs. Labor	at	91		\$ 63.7
	Hrs. Labor	at			\$
	Hrs. Compressor at				\$
	Compensation Ins. at \$	per C.			\$ 2.26
	Trucking				\$ 1.2
	Pav't Patch	B.P.			\$
					\$
					\$
	O'head				\$
					\$ 28.07

112-1450
Before Taving

St. Charlotte
Pl. Ave. No. 14.

Name of Owner
Gustave Cohen.

Labor and Mat'l. Report July 7 19 50

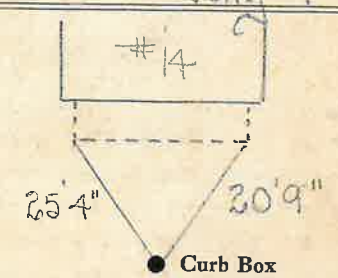

4" Main Elev. of Main at tap 5'

Gate at ● ● Gate at

● Curb Box