

### LABOR AND MATERIALS

1	Copper <small>Lead</small>	Connection $\frac{3}{4}$ "	\$ 1.23
1	Curb	{ Cock Valve T. S. & V. } $\frac{3}{4}$ in.	\$ 1.68
1	Service Box <small>Old returned</small>	{ Short $3\frac{1}{2} \times 4\frac{1}{2}$ Long $4\frac{1}{2} \times 5\frac{1}{2}$ Buff. or Rdway }	\$ 1.54
20	Ft. $\frac{3}{4}$ in.	{ Copper Galv Iron Cast Iron } Pipe at 17	\$ 3.40
	Nipples	in. at	\$
1	Bushings	$\frac{3}{4}$ to $\frac{1}{2}$ in. at	\$ .03
	Red'g Inc'g	{ Couplings to in. at	\$
	Union	in. at	\$
	Meter	in. at	\$
	Lead Joints	at	\$
	Leadite Joints	at	\$
	Hrs. Foreman	at	\$
2	Hrs. Chauffeur	at $6\frac{1}{2}$	\$ 1.25
5	Hrs. Tapper	at $1$	\$ 3.13
8	Hrs. Labor	at $45$	\$ 3.60
	Hrs. Labor	at	\$
	Hrs. Compressor	at	\$
	Compensation Ins.		\$ .25
	Trucking		\$ 1.-
	Builders Use of Water	<i>Patch -</i>	\$ 5.00
	<i>Taply Holes</i>		\$
			\$
			\$
			\$
			\$
			\$ 22.11

45 - - 1939

St.  
Ph  
Ave. No. 16

Charlotte



Name of Owner

*Atkins*

Labor and Mat'l. Report

*July 13*

1939

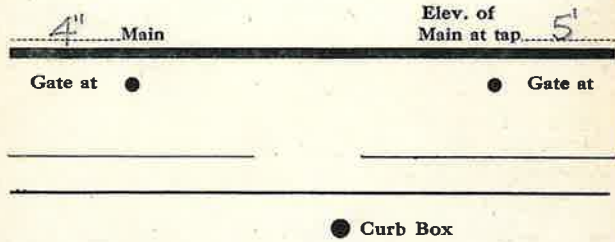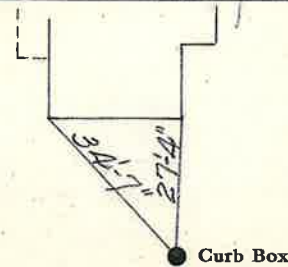

*oil shut off*