


LABOR AND MATERIALS

1	Copper Lead	} Connection	3/4"	\$	
1	Curb			} Cock Valve F.S. & V.	3/4" in.
1	Service box Old returned	} Short 3 1/2 x 4 1/2 Long 4 1/2 x 5 1/2			
13	Ft. 3/4" in.		} Copper C.I. C.I.	} Pipe at	\$
	Nipples	in. at			\$
	Bushings	to in. at			\$
	Red'g Inc'g	} Coupl'gs	to in. at	\$	
	Union			in. at	\$
	Meter	in. at	\$		
	Compound Joints	at	\$		
	Maintenance Foreman		\$		
	Hrs. Water Maint. Man	—1 at	\$		
	Hrs. Water Maint. Man	—2 at	\$		
	Hrs. Garage Foreman	at	\$		
	Hrs. Labor	at	\$		
	Hrs. Compressor	at	\$		
	Trucking		\$		
	Pav't Patch		\$		
			\$		
			\$		
			\$		
			\$		

St. CHARLOTTE
~~Pi~~
 Ave. No. 3-5

Name of Owner _____

Labor and Mat'l. Report JULY 1935

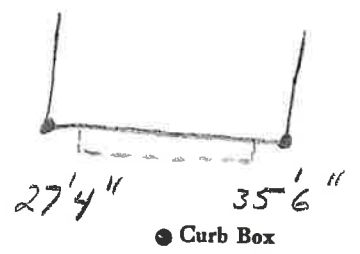

4" Main Elev. of
Main at tap 52.1

Gate at ● ● Gate at

● Curb Box