

### LABOR AND MATERIALS

1	Copper Lead	} Connection	$\frac{3}{4}$		\$ 2.80
1	Curb	} Clock Valve I. S. & V.	$\frac{3}{4}$	in.	\$ 3.60
1	Service box Old returned	} Short $3\frac{1}{2} \times 4\frac{1}{2}$ Long $4\frac{1}{2} \times 5\frac{1}{2}$ Buff or Rdway			\$ 5.80
24	Ft.	} Copper Galv. Iron Cast Iron	$\frac{3}{4}$	in. } Pipe at	35 8.40
	Nipples	in. at			\$
	Bushings	to in. at			\$
	Red'g Inc'g	} Couplings	to	in. at	\$
	Union	in. at			\$
	Meter	in. at			\$
	Lead Joints	at			\$
	Compound Joints	at			\$
	Hrs. Foreman	at			\$
	Hrs. Chauffeur	at			\$
	Hrs. Tapper	at			\$
	Hrs. Labor	at			\$
	Hrs. Labor	at			\$
	Hrs. Compressor	at			\$
	Compensation Ins.				\$
	Trucking				\$ 1-
	Builders Use of Water				\$
	Tap by Miller				\$
					\$
					\$
					\$
					\$


101-47

St.  
Pl. 13  
Ave. No.

Cherry

Name of Owner  
Pagony

Labor and Mat'l. Report Aug 18 19 47

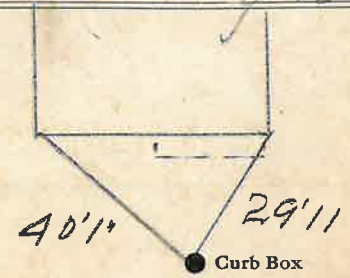

4 Main Elev. of Main at tap 6

Gate at ● ● Gate at

● Curb Box  
OUTSIDE CLEAN OUT 2"6" FROM  
CURB BOX NEXT TO SIDE WALK