


LABOR AND MATERIALS

1	Copper Lead	Connection	3/4"	\$
1	Curb	Cock Valve T.S.&V.	3/4" in.	\$
1	Service box Old returned	Short 3 1/2 x 4 1/2 Long 4 1/2 x 5 1/2		\$
9	Ft.	3/4" in. Copper Crt. Crt.	Pipe at	\$
	Nipples	in. at		\$
1	Bushings	3/4 to 1/2 in. at		\$
	Red'g Inc'g	Coupl'gs to in. at		\$
	Union	in. at		\$
	Meter	in. at		\$
	Compound Joints	at		\$
	Maintenance Foreman			\$
	Hrs. Water Maint. Man	1 at		\$
	Hrs. Water Maint. Man	2 at		\$
	Hrs. Garage Foreman	at		\$
	Hrs. Labor	at		\$
	Hrs. Compressor	at		\$
	Trucking			\$
	Pav't Patch			\$
				\$
				\$
CHERRY St. Pt. Ave. No. 17-19

Name of Owner

Labor and Mat'l. Report AUG. 1925

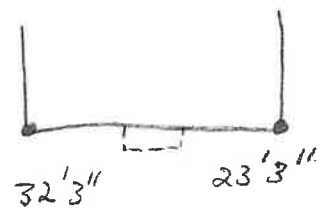

● Curb Box

4" Main

Elev. of Main at tap 5'

Gate at ●

● Gate at

● Curb Box