


LABOR AND MATERIALS

1	Copper } Connection <sup>3/4"</sup>	\$
	Lead }	
1	Curb } Cock Valve } <sup>3/4"</sup> in.	\$
1	Service box } { Short 3 1/2 x 4 1/2 } Old returned } { Long 4 1/2 x 5 1/2 }	\$
7	Ft. <sup>3/4"</sup> in. } { Copper } Pipe at	\$
	Nipples in. at	\$
1	Bushings <sup>3/4</sup> to <sup>1/2</sup> in. at	\$
	Red'g } Inc'g } Coupl'gs to in. at	\$
	Union in. at	\$
	Meter in. at	\$
		\$
	Compound Joints at	\$
	Maintenance Foreman	\$
	Hrs. Water Maint. Man-1 at	\$
	Hrs. Water Maint. Man-2 at	\$
	Hrs. Garage Foreman at	\$
	Hrs. Labor at	\$
	Hrs. Compressor at	\$
		\$
	Trucking	\$
	Pav't Patch	\$
		\$
		\$
		\$
		\$

St. CHERRY  
~~Pl.~~  
 Ave. No. 21

Name of Owner \_\_\_\_\_

Labor and Mat'l. Report SEPT 19 26

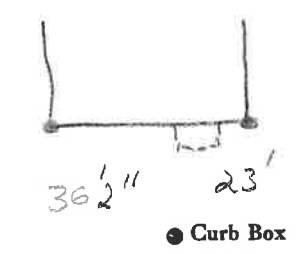

4" Main                      Elev. of Main at tap 5'  
 Gate at ●    ● Gate at

● Curb Box