

LABOR AND MATERIALS


1	Copper	Connection	_____	\$	_____
	Lead				
	Curb	Cock	_____ in.	\$	_____
		Valve			
		T. S. & V.			
	Service box	Short 3½ x 4½			
	Old returned	Long 4½ x 5½			
				\$	_____
6	Ft.	3/4 in.	{ Copper } { G. I. } { C. I. }	Pipe at	\$ _____
	Nipples	in. at		\$	_____
	Bushings	to in. at		\$	_____
	Red'g				
	Inc'g	Coupl'gs to in. at		\$	_____
	Union	in. at		\$	_____
	Meter	in. at		\$	_____
				\$	_____
	Compound Joints	at		\$	_____
	Maintenance Foreman			\$	_____
	Hrs. Water Maint. Man-1	at		\$	_____
	Hrs. Water Maint. Man-2	at		\$	_____
	Hrs. Garage Foreman	at		\$	_____
	Hrs. Labor-	at		\$	_____
	Hrs. Compressor	at		\$	_____
				\$	_____
	Trucking			\$	_____
	Pav't Patch			\$	_____
				\$	_____
				\$	_____
CHEERY

St. Pt. Ave. No. 23

Name of Owner _____

Labor and Mat'l. Report JUNE 1917

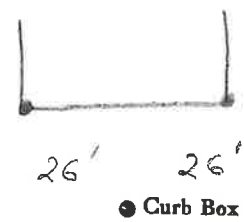

4" Main

Elev. of Main at tap _____

Gate at ●

● Gate at _____

● Curb Box