

LABOR AND MATERIALS


_____	Copper } Connection _____	\$ _____
_____	Lead } _____	\$ _____
_____	Curb } Cock _____ in. _____	\$ _____
	} Valve } _____	
	} T.S. & V. } _____	
_____	Service box { Short 3-1/2 x 4-1/2 } _____	\$ _____
_____	Old returned { Long 4-1/2 x 5-1/2 } _____	\$ _____
_____	Ft. _____ in. { Copper } Pipe at _____	\$ _____
	} G.I. }	
	} C.I. }	
_____	Nipples _____ in. at _____	\$ _____
_____	Bushings _____ to _____ in. at _____	\$ _____
_____	Red'g _____	\$ _____
_____	Inc'g _____	\$ _____
_____	Union _____ in. at _____	\$ _____
_____	Meter _____ in. at _____	\$ _____
_____	_____	\$ _____
_____	Compound Joints at _____	\$ _____
_____	Maintenance Foreman _____	\$ _____
_____	Hrs. Water Maint. Man - 1 at _____	\$ _____
_____	Hrs. Water Maint. Man - 2 at _____	\$ _____
_____	Hrs. Garage Foreman _____ at _____	\$ _____
_____	Hrs. Labor _____ at _____	\$ _____
_____	Hrs. Compressor at _____	\$ _____
_____	_____	\$ _____
_____	Trucking _____	\$ _____
_____	Pav't Patch _____	\$ _____
_____	_____	\$ _____
_____	_____	\$ _____
St. _____
Pl. _____
Ave. No. _____

Name of Owner
Cherry 24

Labor and Mat'l. Report 19

Seus

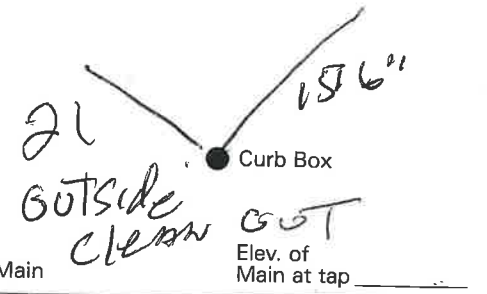

Gate at ● ● Gate at

● Curb Box

LABOR AND MATERIALS

Copper	}	Connection	-----	\$				
Lead			-----	\$				
Curb	{	Cock Valve T. S. & V.	-----	in.	\$			
Service Box			-----	\$				
Old returned	}	Short 3 1/2 x 4 1/2	-----	\$				
		Long 4 1/2 x 5 1/2	-----	\$				
		Buff. or Rdway	-----	\$				
22 Ft. ^{3/4}	}	Copper	Pipe at	-----	\$			
		Galv Iron						
		Cast Iron						
Nipples	-----	in. at	-----	\$				
Bushings	-----	to	-----	in. at	-----	\$		
Red'g	}	Couplings	-----	to	-----	in. at	-----	\$
Inc'g			-----	\$				
Union	-----	in. at	-----	\$				
Meter	-----	in. at	-----	\$				
Lead Joints	-----	at	-----	\$				
Leadite Joints	-----	at	-----	\$				
Hrs. Foreman	-----	at	-----	\$				
Hrs. Chauffeur	-----	at	-----	\$				
Hrs. Tapper	-----	at	-----	\$				
Hrs. Labor	-----	at	-----	\$				
Hrs. Labor	-----	at	-----	\$				
Hrs. Compressor	-----	at	-----	\$				
Compensation Ins.	-----		-----	\$				
Trucking	-----		-----	\$				
Builders Use of Water	-----		-----	\$				
	-----		-----	\$				
	-----		-----	\$				
St.

Pl.


Cherry

Ave. No. *24*

Name of Owner

Labor and Mat'l. Report

Aug. 22 19 *39*

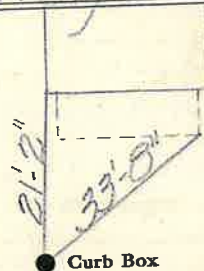

4'
Main

Elev. of
Main at top *5'*

Gate at ●

● Gate at

● Curb Box

28th Avenue St