


LABOR AND MATERIALS

Copper } Connection _____ \$ _____
 Lead }
 Curb } Cock _____ in. _____ \$ _____
 Valve }
 T.S. & V. }
 Service box { Short 3-1/2 x 4-1/2 } _____ \$ _____
 Old returned { Long 4-1/2 x 5-1/2 }
 Ft. _____ in. { Copper } Pipe at _____ \$ _____
 { G.I. }
 { C.I. }
 Nipples _____ in. at _____ \$ _____
 Bushings _____ to _____ in. at _____ \$ _____
 Red'g _____
 Inc'g _____
 Union _____ in. at _____ \$ _____
 Meter _____ in. at _____ \$ _____
 _____ \$ _____
 Compound Joints at _____ \$ _____
 Maintenance Foreman _____ \$ _____
 Hrs. Water Maint. Man - 1 at _____ \$ _____
 Hrs. Water Maint. Man - 2 at _____ \$ _____
 Hrs. Garage Foreman _____ at _____ \$ _____
 Hrs. Labor _____ at _____ \$ _____
 Hrs. Compressor at _____ \$ _____
 _____ \$ _____
 Trucking _____ \$ _____
 Pav't Patch _____ \$ _____
 _____ \$ _____
 _____ \$ _____
 _____ \$ _____
 _____ \$ _____

CHERRY St. 27
 Pl. Ave. No.
 Name of Owner PAPA

Labor and Mat'l. Report 19

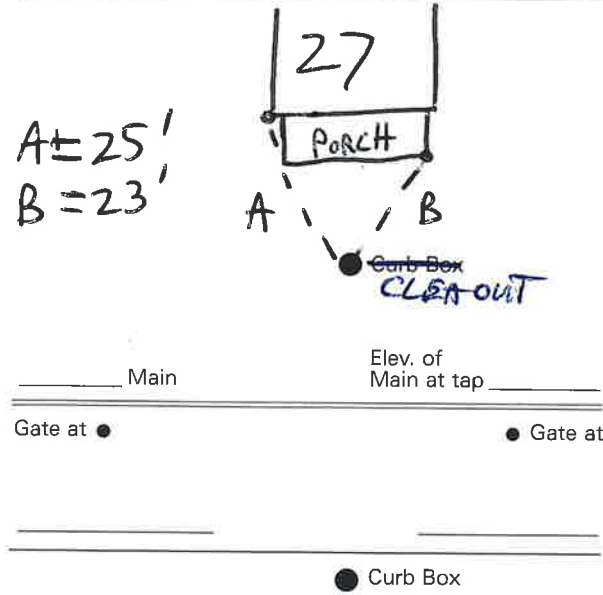

CLEAN OUT 8' SOUTH OF CURB BOX

LABOR AND MATERIALS

1	Copper Lead	Connection	3/4"	\$	_____
1	Curb	Cock Valve T.S. & V.	3/4" in.	\$	_____
1	Service box Old returned	{ Short 3 1/2 x 4 1/2 Long 4 1/2 x 5 1/2 }		\$	_____
10	Ft.	3/4" in. { Copper G.I. G.I. }	Pipe at	\$	_____
	Nipples	in. at		\$	_____
	Bushings	to in. at		\$	_____
	Red'g Inc'g	Coupl'gs	to in. at	\$	_____
	Union	in. at		\$	_____
	Meter	in. at		\$	_____
	Compound Joints	at		\$	_____
	Maintenance Foreman			\$	_____
	Hrs. Water Maint. Man	—1 at		\$	_____
	Hrs. Water Maint. Man	—2 at		\$	_____
	Hrs. Garage Foreman	at		\$	_____
	Hrs. Labor	at		\$	_____
	Hrs. Compressor	at		\$	_____
	Trucking			\$	_____
	Pav't Patch			\$	_____
				\$	_____
				\$	_____
				\$	_____
				\$	_____

St. CHERRY
~~Pl.~~
 Ave. No. 27

Name of Owner _____
 Labor and Mat'l. Report JUNE 1936



17'1" 27'2"

● Curb Box

4" Main Elev. of Main at tap 6'
 Gate at ● Gate at

● Curb Box