


LABOR AND MATERIALS

1	Copper Lead	} Connection $\frac{3}{4}$ "	\$
1	Curb		} Cock Valve T.S. & V. } $\frac{3}{4}$ " in.
1	Service box Old returned	} Short $3\frac{1}{2} \times 4\frac{1}{2}$ Long $4\frac{1}{2} \times 5\frac{1}{2}$ }	
27	Ft. $\frac{3}{4}$ "		} Copper G.I. C.I. }
	Nipples	in. at \$	
	Bushings	to in. at \$	
	Red'g } Inc'g }	Coupl'gs to in. at \$	
	Union	in. at \$	
	Meter	in. at \$	
	Compound Joints	at \$	
	Maintenance Foreman	\$	
	Hrs. Water Maint. Man-1	at \$	
	Hrs. Water Maint. Man-2	at \$	
	Hrs. Garage Foreman	at \$	
	Hrs. Labor	at \$	
	Hrs. Compressor	at \$	
	Trucking	\$	
	Pav't Patch	\$	
		\$	
		\$	
St. CHERRY
~~Pl.~~ Ave. No. 35
 Name of Owner
 TAX ID # 303.17-2-21

Labor and Mat'l. Report JULY 1930

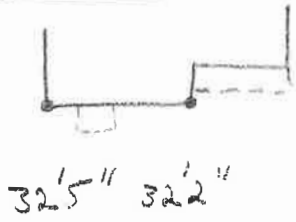

● Curb Box

12" Main Elev. of Main at tap 5'
 Gate at ● Gate at ●

● Curb Box