

LABOR AND MATERIALS

| | | | | | | |
|---|-------------------------|----------------------------|-----------|----|---|----|
| 1 | Copper | } Connection | 3/4 | \$ | | |
| | Lead | | | | | |
| 1 | Curb | } Cock Valve T. S. & V. | } 3/4 in. | \$ | | |
| 1 | Service box | | | | } Short 3 1/2 x 4 1/2 Long 4 1/2 x 5 1/2 | \$ |
| | Old returned | | | | | |
| 9 | Ft. 3/4 in. | } Copper G.I. G.I. | } Pipe at | \$ | | |
| 1 | Nipples 3/4 x 3/8 in. | | | | \$ | |
| | Bushings to in. | | | | \$ | |
| | Red'g Inc'g } Coupl'gs | to in. | \$ | | | |
| | Union | in. | \$ | | | |
| | Meter | in. | \$ | | | |
| | | | \$ | | | |
| | Compound Joints | at | \$ | | | |
| | Maintenance Foreman | | \$ | | | |
| | Hrs. Water Maint. Man-1 | at | \$ | | | |
| | Hrs. Water Maint. Man-2 | at | \$ | | | |
| | Hrs. Garage Foreman | at | \$ | | | |
| | Hrs. Labor | at | \$ | | | |
| | Hrs. Compressor | at | \$ | | | |
| | | | \$ | | | |
| | Trucking | | \$ | | | |
| | Pav't Patch | | \$ | | | |
| | | | \$ | | | |
| | | | \$ | | | |
CHERRY

St. ~~Pl.~~ Ave. No. 36

Name of Owner

Labor and Mat'l. Report

NOV 1925

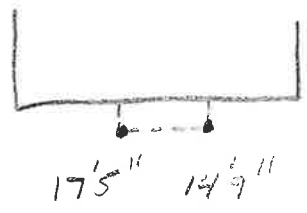

● Curb Box

12" Main

Elev. of Main at tap 5'

Gate at ●

● Gate at

● Curb Box