

LABOR AND MATERIALS


1	Copper Lead	} Connection	3/4"		\$
1	Curb	} Cock Valve T.S. & V.	3/4" in.		\$
1	Service box Old returned	} Short 3 1/2 x 4 1/2 Long 4 1/2 x 5 1/2			\$
24	Ft.	} Copper G.I. C.I.	3/4" in.	} Pipe at	\$
	Nipples	in. at			\$
1	Bushings	3/4 to 1/2	in. at		\$
1	Red'g In'g	} Coupl'gs	BRASS	to in. at	\$
	Union	in. at			\$
	Meter	in. at			\$
					\$
	Compound Joints	at			\$
	Maintenance Foreman				\$
	Hrs. Water Maint. Man	—1 at			\$
	Hrs. Water Maint. Man	—2 at			\$
	Hrs. Garage Foreman	at			\$
	Hrs. Labor	at			\$
	Hrs. Compressor	at			\$
					\$
	Trucking				\$
	Pav't Patch				\$
					\$
					\$
CHERRY

St.
—Pr.
Ave. No. 37

Name of Owner _____

Labor and Mat'l. Report JULY 1927

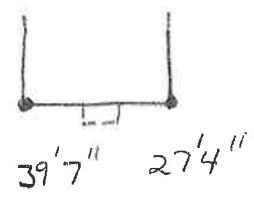

● Curb Box

12" Main

Elev. of
Main at tap 4'

Gate at ● ● Gate at

● Curb Box