


LABOR AND MATERIALS

1	Copper Lead	Connection	3/4	\$	2.80
1	Curb	Clock Valve T.S. & V.	3/4 in.	\$	3.60
1	Service box Old returned	Short 3 1/2 X 4 1/2 Long 4 1/2 X 5 1/2 Buff or Rdway		\$	5.90
10	Ft.	3/4 in. Copper Galv. Iron Cast Iron	Pipe at 35	\$	3.50
	Nipples	in. at		\$	
	Bushings	to in. at		\$	
	Red'g Inc'g	Couplings	to in. at	\$	
	Union	in. at		\$	
	Meter	in. at		\$	
	Lead Joints	at		\$	
	Compound Joints	at		\$	
	Hrs. Foreman	at		\$	
	Hrs. Chauffeur	at		\$	
	Hrs. Tapper	at		\$	
	Hrs. Labor	at		\$	
	Hrs. Labor	at		\$	
	Hrs. Compressor	at		\$	
	Compensation Ins.			\$	
	Trucking			\$	1.50
	Builders Use of Water			\$	
	Tap by Miller			\$	
				\$	
				\$	
				\$	
				\$	

St. Cherry
Pl. 90
Ave. No. 90

Name of Owner Constantine

Labor and Mat'l. Report Aug 22 1947

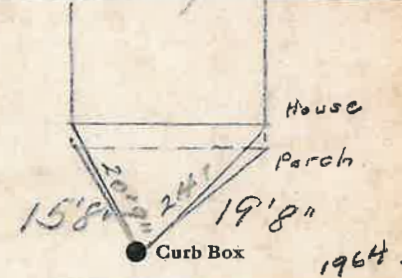

12 Main Elev. of Main at tap 5

Gate at ● Gate at ●

TAX ID # 303.17-1-2

● Curb Box