


LABOR AND MATERIALS

1	Copper Lead	Connection	\$
1	Curb	Cock Valve } 3/4 in. T.S. & V. }	\$
1	Service box Old returned	Short 3 1/2 x 4 1/2 } Long 4 1/2 x 5 1/2 }	\$
9	Ft. 3/4 in.	Copper } G. I. } Pipe at G. I. }	\$
	Nipples	in. at	\$
	Bushings	to in. at	\$
	Red'g Inc'g	Coupl'gs to in. at	\$
	Union	in. at	\$
	Meter	in. at	\$
	Compound Joints	at	\$
	Maintenance Foreman		\$
	Hrs. Water Maint. Man-1	at	\$
	Hrs. Water Maint. Man-2	at	\$
	Hrs. Garage Foreman	at	\$
	Hrs. Labor	at	\$
	Hrs. Compressor	at	\$
	Trucking		\$
	Pav't Patch		\$
			\$
			\$
St. ~~Pl.~~ No. 44
 Name of Owner CHERRY

Labor and Mat'l. Report SEPT 19 21

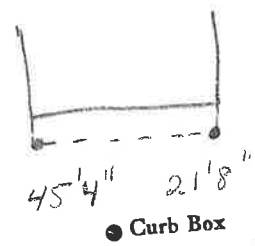

12" Main Elev. of Main at tap 4'
 Gate at ● ● Gate at

● Curb Box

SHUT OFF IN 1932?