


LABOR AND MATERIALS

1	Copper	} Connection	3/4	_____	\$ _____				
	Lead								
1	Curb	} Cock Valve T.S. & V.	} 3/4 in.	_____	\$ _____				
1	Service box					} Short 3 1/2 x 4 1/2	} _____	\$ _____	
	Old returned								} Long 4 1/2 x 5 1/2
26	Ft. 3/4 in.	} Copper	} _____	} Pipe at _____	\$ _____				
						} C.I.	} _____	} _____	\$ _____
	Nipples	_____ in. at _____			\$ _____				
	Bushings	_____ to _____ in. at _____			\$ _____				
	Red'g	} Coupl'gs. _____ to _____ in. at _____			\$ _____				
	Inc'g					\$ _____			
	Union	_____ in. at _____			\$ _____				
	Meter	_____ in. at _____			\$ _____				
					\$ _____				
	Compound Joints	at _____			\$ _____				
	Maintenance Foreman	_____			\$ _____				
	Hrs. Water Maint. Man-1	at _____			\$ _____				
	Hrs. Water Maint. Man-2	at _____			\$ _____				
	Hrs. Garage Foreman	at _____			\$ _____				
	Hrs. Labor	at _____			\$ _____				
	Hrs. Compressor	at _____			\$ _____				
					\$ _____				
	Trucking	_____			\$ _____				
	Pav't Patch	_____			\$ _____				
					\$ _____				
					\$ _____				
					\$ _____				
					\$ _____				

St. _____
 Pt. _____
 Ave. No. 47
CHERRY
 Name of Owner _____
 TAX ID # 303.17-2-16

Labor and Mat'l. Report JULY 1933

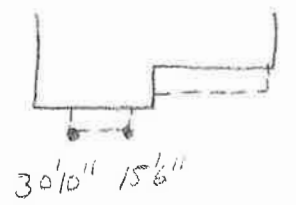

● Curb Box

12" Main Elev. of Main at tap 4'
 Gate at ● Gate at ●

● Curb Box