

LABOR AND MATERIALS

1	Copper } Connection $\frac{3}{4}$	\$
	Lead } $\frac{3}{4}$ in.	\$
1	Curb } Cock } $\frac{3}{4}$ in.	\$
	} Valve } $\frac{3}{4}$ in.	\$
	} T.S. & V. }	\$
1	Service box { Short $3\frac{1}{2} \times 4\frac{1}{2}$	\$
	Old returned { Long $4\frac{1}{2} \times 5\frac{1}{2}$	\$
7	Ft. $\frac{3}{4}$ in. { Copper } Pipe at	\$
	} C.I.	\$
	} C.I.	\$
	Nipples in. at	\$
	Bushings to in. at	\$
1	Red'g } Coupl'gs $\frac{3}{4}$ to in. at	\$
	Inc'g }	\$
	Union in. at	\$
	Meter in. at	\$
	Compound Joints at	\$
	Maintenance Foreman	\$
	Hrs. Water Maint. Man-1 at	\$
	Hrs. Water Maint. Man-2 at	\$
	Hrs. Garage Foreman at	\$
	Hrs. Labor at	\$
	Hrs. Compressor at	\$
	Trucking	\$
	Pav't Patch	\$
		\$
		\$
CHERRY

St. ~~Pl.~~
Ave. No. 54

Name of Owner

Labor and Mat'l. Report

JUNE 1925

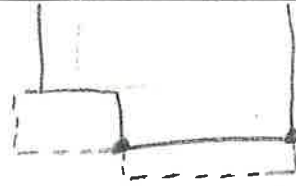

23' 28'8"
● Curb Box

12" Main

Elev. of Main at tap 4'

Gate at ●

● Gate at

● Curb Box