

LABOR AND MATERIALS


1	Copper } Lead }	Connection ^{3/4}		\$
1	Curb } T.S. & V. }	Cock Valve } 3/4 in.		\$
1	Service box } Old returned }	Short 3 1/2 x 4 1/2 } Long 4 1/2 x 5 1/2 }		\$
7	Ft. ^{3/4} in.	Copper } C.I. } C.I. }	Pipe at	\$
	Nipples	in. at		\$
	Bushings	to in. at		\$
	Red'g } Inc'g }	Coupl'gs	to in. at	\$
	Union	in. at		\$
	Meter	in. at		\$
	Compound Joints	at		\$
	Maintenance Foreman			\$
	Hrs. Water Maint. Man—1	at		\$
	Hrs. Water Maint. Man—2	at		\$
	Hrs. Garage Foreman	at		\$
	Hrs. Labor	at		\$
	Hrs. Compressor	at		\$
	Trucking			\$
	Pav't Patch			\$
				\$
				\$
CHERRY

St. PT.
Ave. No. 56

Name of Owner _____

Labor and Mat'l. Report NOV 1927

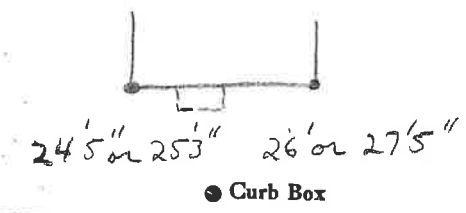

12" Main Elev. of Main at tap 4'

Gate at ● ● Gate at

● Curb Box