

LABOR AND MATERIALS

Copper Lead	} Connection	3/4			
				\$	1.35
1 Curb	{ Cock Valve T. S. & V.	3/4	in.	\$	1.80
Service Box Old returned	{ Short 3 1/2 x 4 1/2 Long 4 1/2 x 5 1/2 Buff or Rdway			\$	same
26 Ft.	{ Copper Galv Iron Cast Iron	3/4	in.	Pipe at 18	\$ 4.68
Nipples			in. at	\$	
Bushings			to in. at	\$	
Red'g Inc'g	{ Couplings		to in. at	\$	
Union			in. at	\$	
Meter			in. at	\$	
Lead Joints at				\$	
Leadite Joints at				\$	
5 Hrs. Foreman at				\$	
Hrs. Chauffeur at		6 2 1/2		\$	8.13
7 Hrs. Tapper at				\$	4.37
10 Hrs. Labor at		45		\$	4.50
Hrs. Labor at				\$	
Hrs. Compressor at				\$	
Compensation Ins.				\$	
Trucking				\$	1.37
Builders Use of Water	Patch			\$	5.00
					\$ 26.70

125 1941


57

St.
Pl.
Ave. No. 47

Cherty

Name of Owner

Labor and Mat'l. Report Sept 24 1941

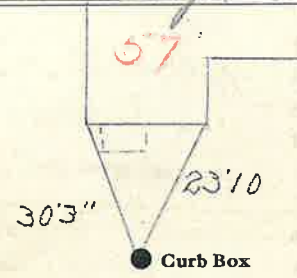

12 Main

Elev. of
Main at tap 5

Gate at ●

● Gate at

● Curb Box