


LABOR AND MATERIALS

1	Copper	} Connection	3/4	\$		
	Lead					
1	Curb	} Cock Valve T.S. & V.	} 3/4 in.	\$		
1	Service box				} Short 3 1/2 x 4 1/2	}
	Old returned					
9	Ft.	} Copper	} 3/4 in.	\$		
					C.I.	C.I.
	Nipples	in. at	\$			
	Bushings	to in. at	\$			
	Red'g	} Coupl'gs	to in. at	\$		
	Inc'g					
	Union	in. at	\$			
	Meter	in. at	\$			
	Compound Joints	at	\$			
	Maintenance Foreman		\$			
	Hrs. Water Maint. Man-1	at	\$			
	Hrs. Water Maint. Man-2	at	\$			
	Hrs. Garage Foreman	at	\$			
	Hrs. Labor	at	\$			
	Hrs. Compressor	at	\$			
	Trucking		\$			
	Pav't Patch		\$			
			\$			
			\$			
St. CHERRY
~~Pl.~~
 Ave. No. 58A-B

Name of Owner _____
 Labor and Mat'l. Report SEPT 1934

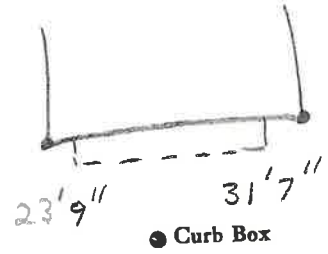

12" Main Elev. of Main at tap 4 1/2'
 Gate at • • Gate at

• Curb Box