

LABOR AND MATERIALS


1	Copper	} Connection	$\frac{3}{4}$ "	\$	_____	
	Lead					
1	Curb	} Cock Valve T. S. & V.	$\frac{3}{4}$ " in.	\$	_____	
1	Service box	} Short $3\frac{1}{2}$ x $4\frac{1}{2}$ Long $4\frac{1}{2}$ x $5\frac{1}{2}$ Buff or Rdway		\$	_____	
	Old returned					
24	Ft.	} Copper C. I. C. I.	$\frac{3}{4}$ " in.	Pipe at	\$ _____	
	Nipples		in. at	\$	_____	
1	Bushings		$\frac{3}{4}$ to $\frac{1}{2}$ in. at	\$	_____	
1	Red'g Incl'g	} Coupl'gs	$\frac{3}{4}$ to	in. at	\$ _____	
	Union		in. at	\$	_____	
	Meter		in. at	\$	_____	
	Lead Joints at			\$	_____	
1	Compound Joints at			\$	_____	
	Maintenance Foreman			\$	_____	
	Hrs. Water Maint. Man-1 at			\$	_____	
	Hrs. Water Maint. Man-2 at			\$	_____	
	Hrs. Garage Foreman at			\$	_____	
24	Hrs. Labor		at	\$	_____	
	Hrs. Compressor at			\$	_____	
	Compensation Ins. at \$		per C	\$	_____	
	Trucking			\$	_____	
	Pav't Patch			\$	_____	
	Remeasured by			\$	_____	
	Gissard & Co			\$	_____	
	1-2-64.			\$	_____	
	O'head			\$	_____	
				\$	_____	

Cherry

St. **59**
~~Pl.~~
 Ave. No. **49**

Name of Owner _____

Labor and Mat'l. Report **Aug. 12** 19**25**

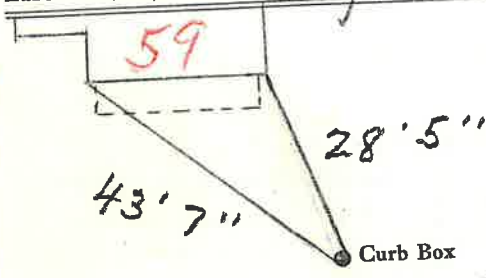

12" Main

Elev. of Main at tap **5'**

Gate at •

• Gate at

• Curb Box

copied
1-2-64.